

This drawing, the works and concepts depicted are the copyright of Stephen George and Partners and may not be reproduced or made use of, either directly or indirectly without express written consent

Do not scale off this drawing

All heights, levels, sizes and dimensions to be checked on site before any work is put to hand

- Revisions:
- A 04-12-01 revised office floor layout
 - B 20-12-01 columns added to office layout
 - C 17-01-02 adjustment to grid layout
 - D 23-01-02 level access doors added
 - E 28-01-02 docking bays removed
 - F 06-02-02 re-alignment of office columns
 - G 19-02-02 over stairwells
 - H 28-02-02 grid naming rationalised
 - I 08-03-02 door numbers added
 - J 08-03-02 external escape stairs added
 - K 18-03-02 five personnel doors removed
 - L 17-05-02 external escape stair removed
 - M 26-06-02 wall thicknesses and door sizes adjusted
- revision to kitchen / cleaner's store
entrance lobby amended
general update
as built issue

AS-BUILT

Birse

ProLogis®
The Global Distribution Solution

STEPHEN GEORGE & PARTNERS
ARCHITECTS & PLANNERS
170 LONDON ROAD
LEICESTER LE2 1ND

SGP.

TEL 0116 247 0557 FAX 0116 254 1095


Project
Unit 2 Lakeside
West Thurrock

Drawing Title
Office / Warehouse Plan
Ground Floor

CAD Ref.	Drawn
7201-005.dwg	gad

Date	Scale at A1
22-11-01	1:200

Project No.	DWG. No.	Revision
7201	005	M

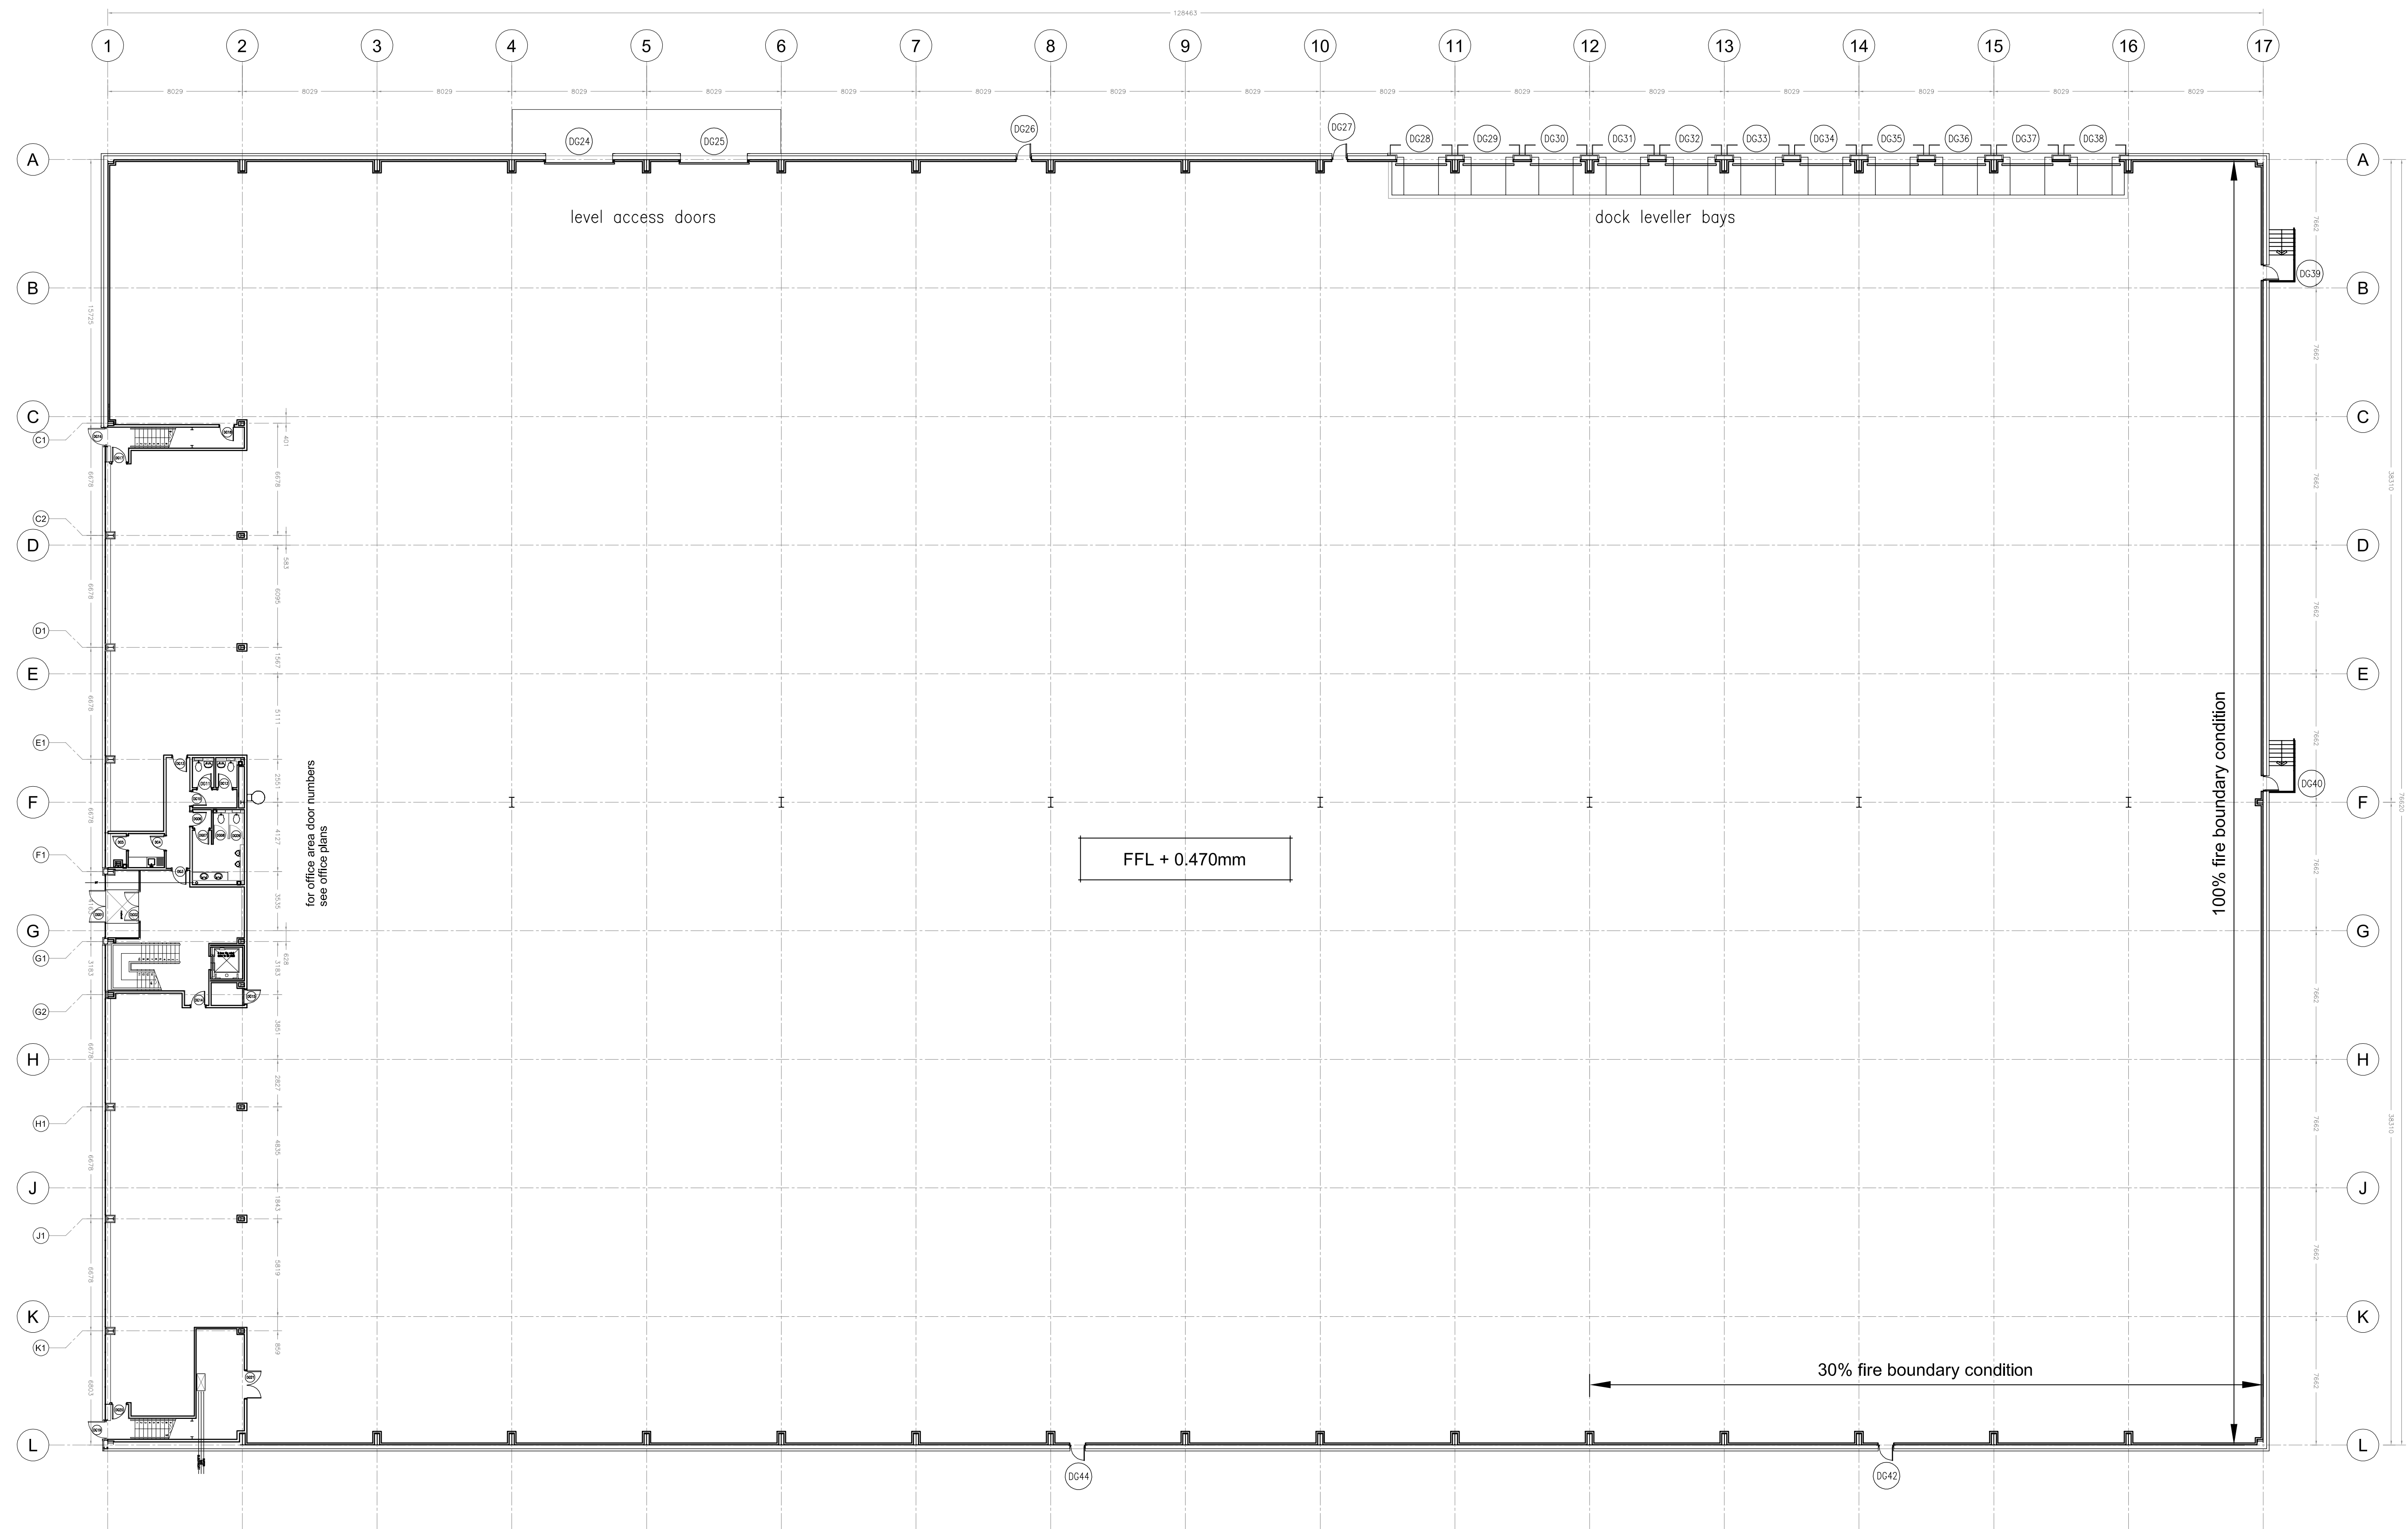

Office / Warehouse Ground Floor Plan
Scale 1:200