




West Elevation
Scale 1:200

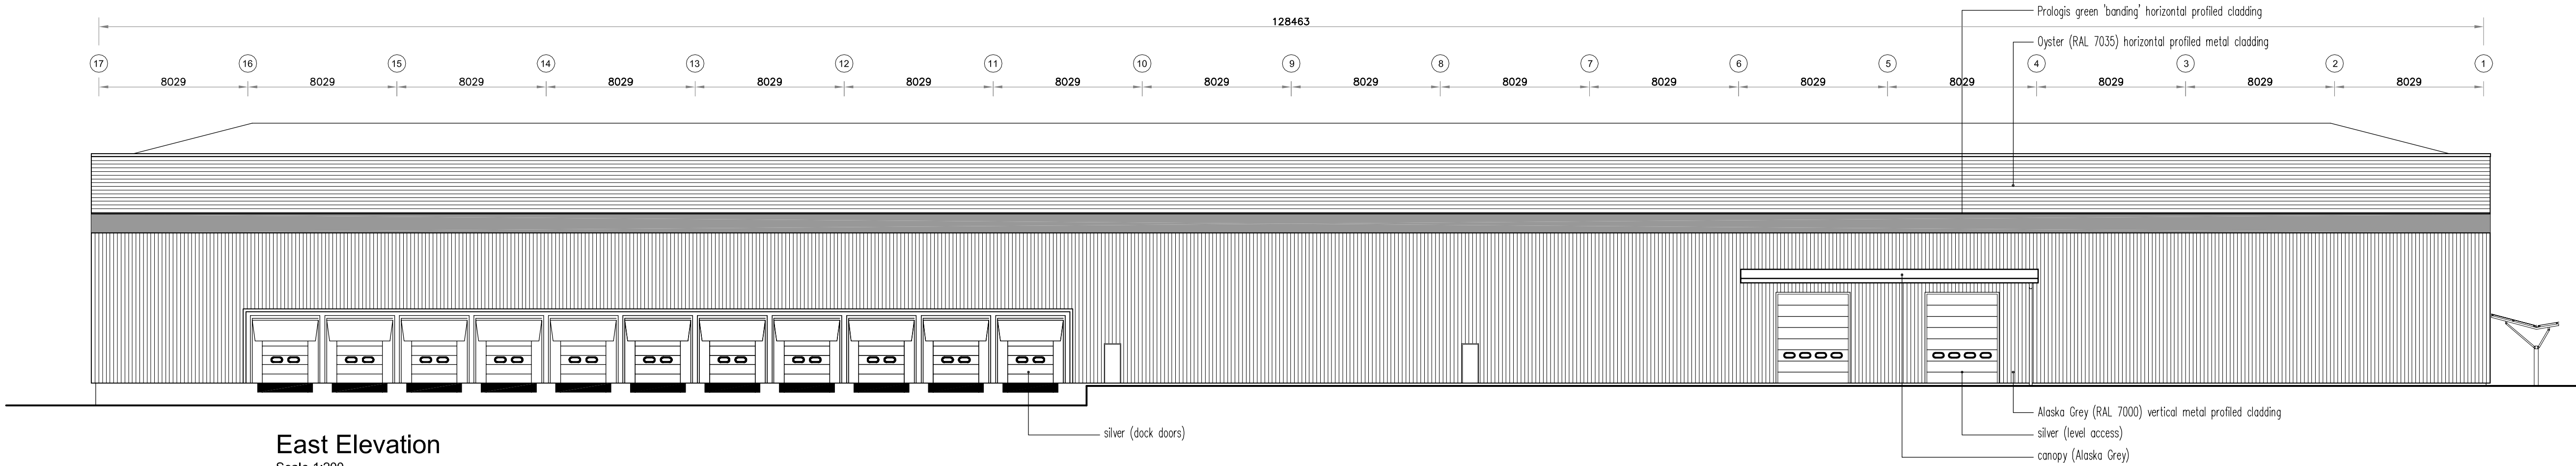

East Elevation
Scale 1:200

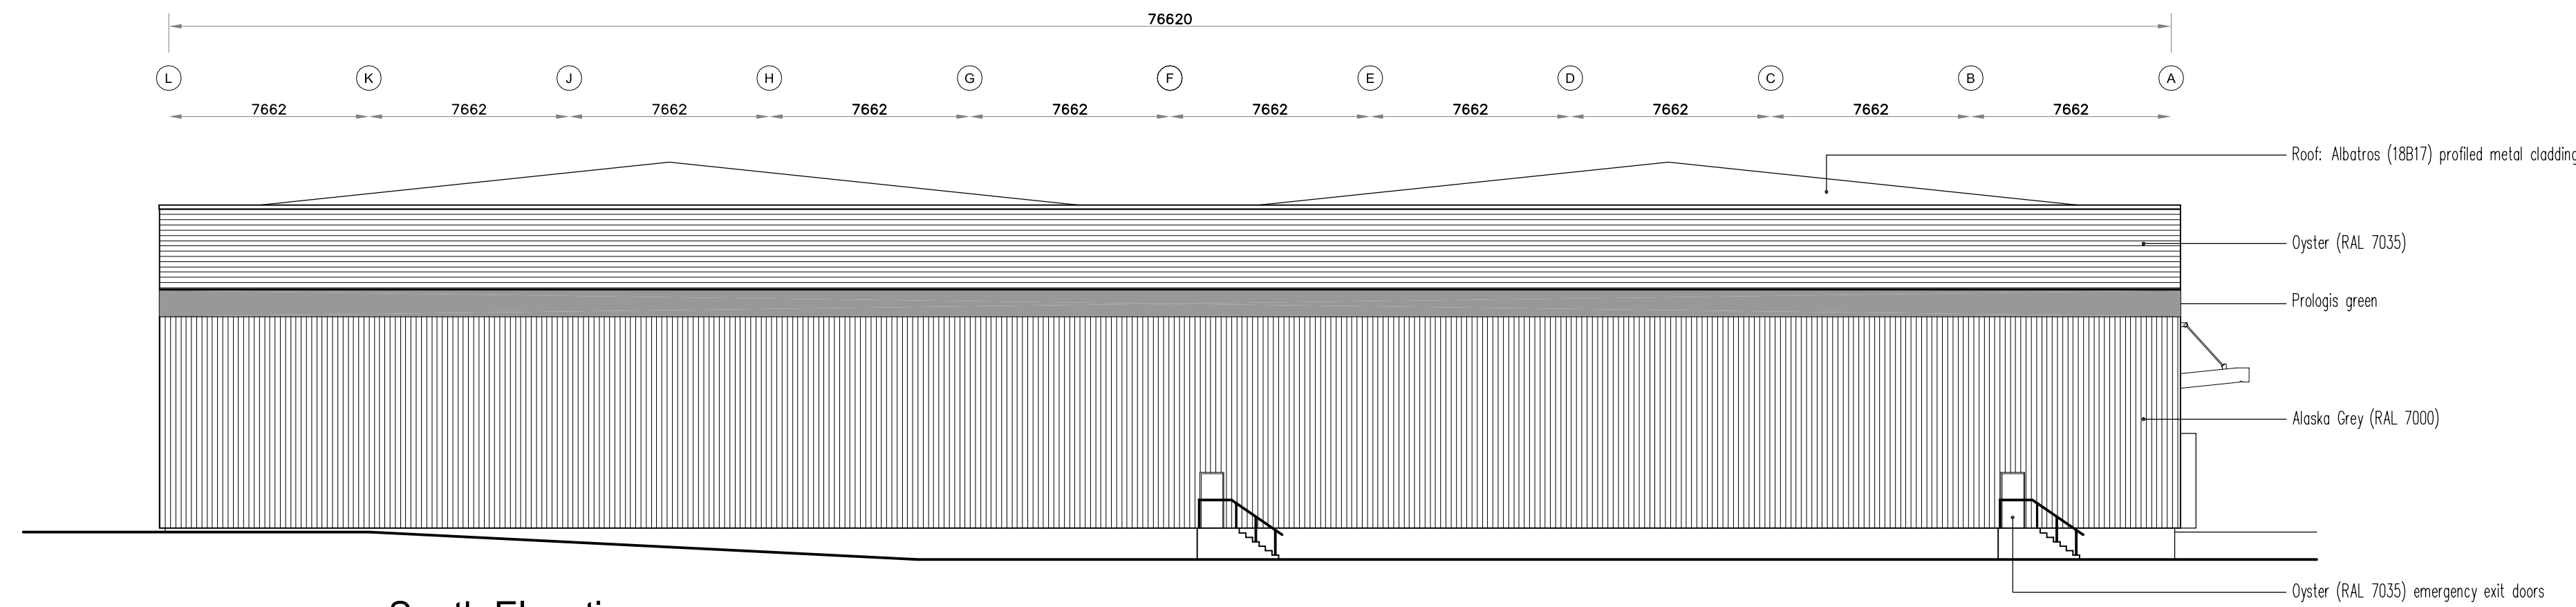

South Elevation
Scale 1:200

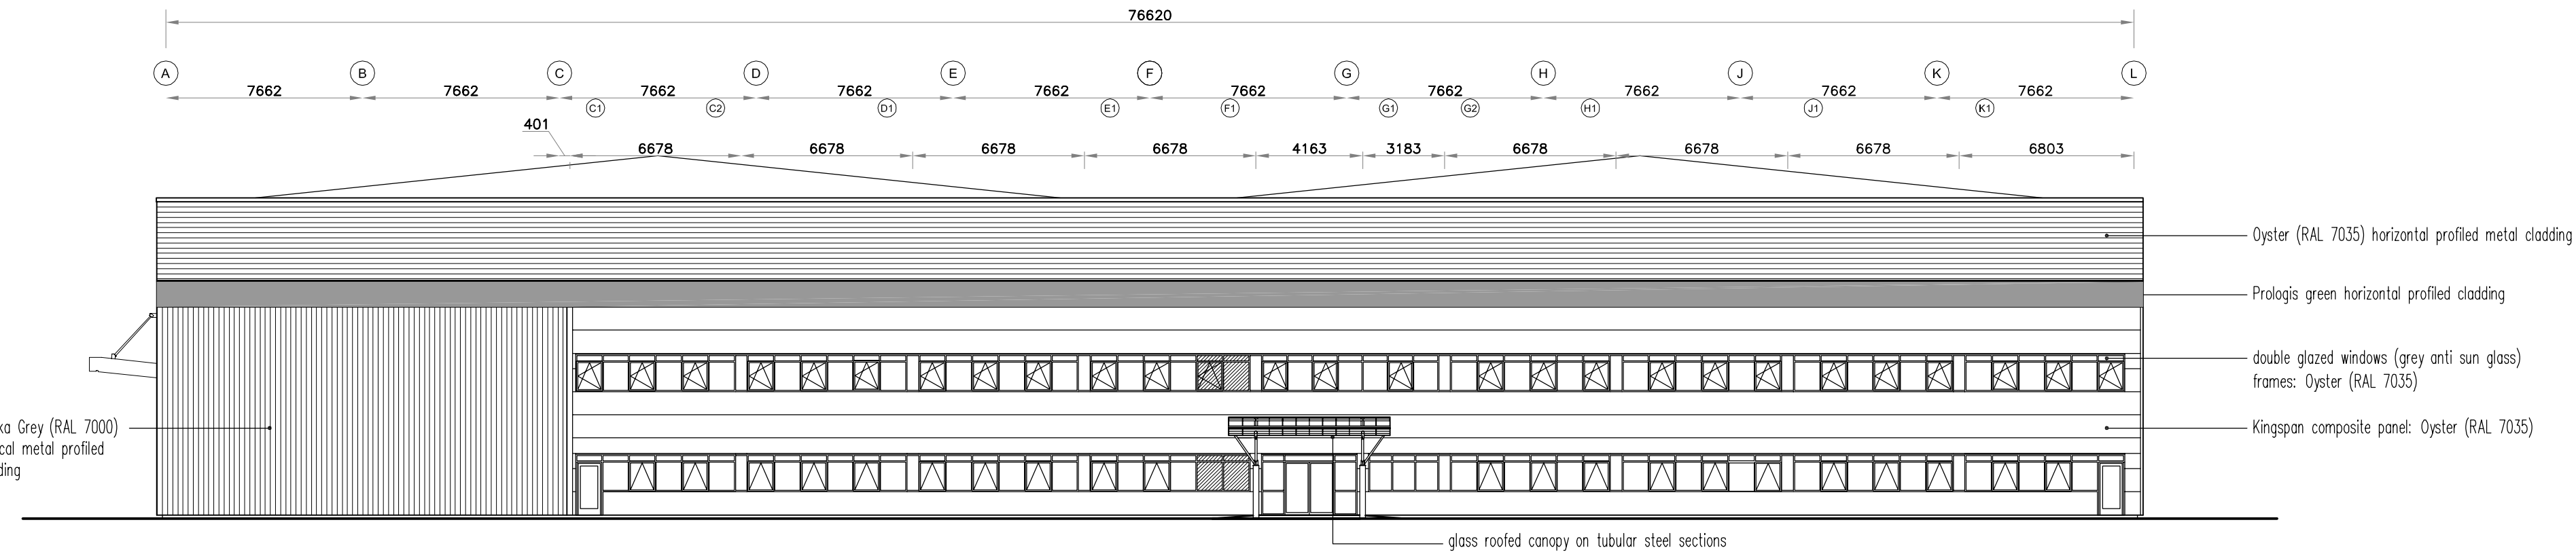

North Elevation
Scale 1:200

This drawing, the works and concepts depicted are the copyright of Stephen George and Partners and may not be reproduced or made use of, either directly or indirectly without express written consent

Do not scale off this drawing

All heights, levels, sizes and dimensions to be checked on site before any work is put to hand

Revisions:

A 10-05-02 position of entrance door amended
position of drop in land amended (west/south elevation)
B 27-06-02 position of rmp from dock access door canopy amended as built issue

KEY

WINDOWS

top hung

tilt turn

AS-BUILT

Birse

ProLogis
The Global Distribution Solution

STEPHEN GEORGE & PARTNERS
ARCHITECTS & PLANNERS
170 LONDON ROAD
LEICESTER LE2 1ND

SGP.

TEL 0116 247 0557 FAX 0116 254 1095

Project
Unit 2 Lakeside
West Thurrock

Drawing Title
Elevations –
Materials Schedule

CAD Ref.
7201-036.dwg
Drawn
ad

Date
17-04-02
Scale at A1
1:200

Project No.
7201
DWG. No.
036
Revision
B